


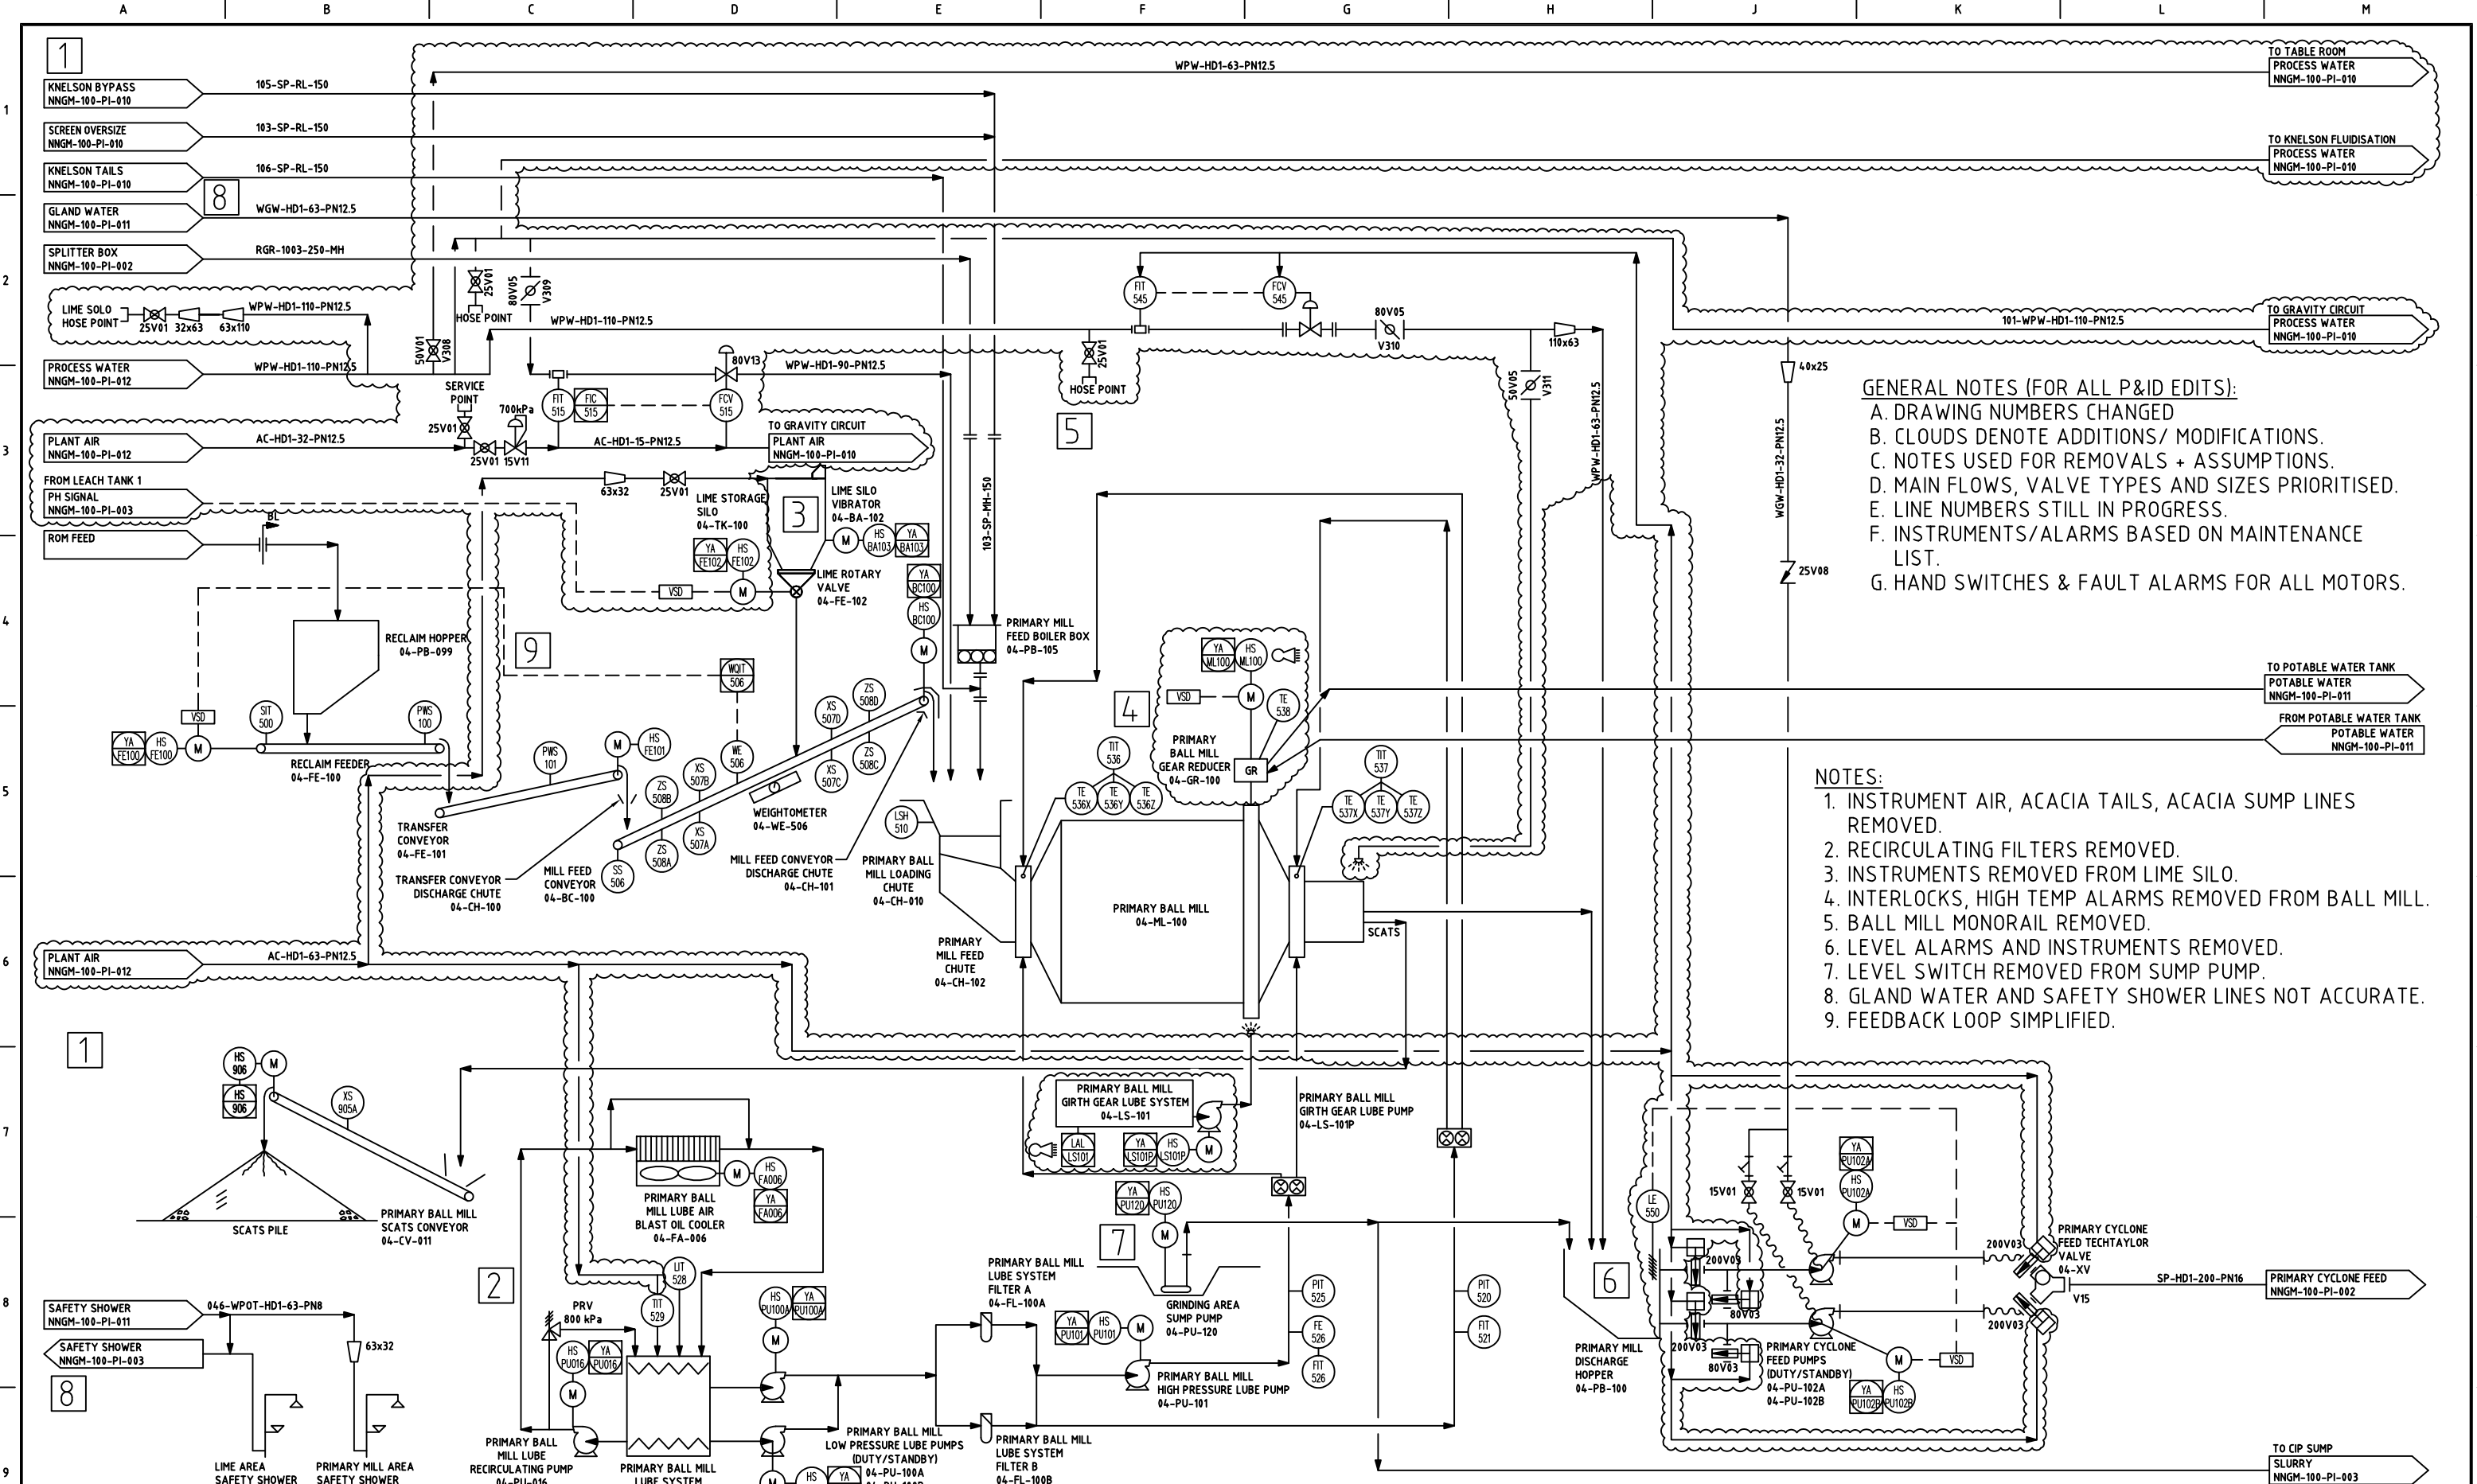


GENERAL NOTES (FOR ALL P&ID EDITS):

- A. DRAWING NUMBERS CHANGED
- B. CLOUDS DENOTE ADDITIONS/ MODIFICATIONS.
- C. NOTES USED FOR REMOVALS + ASSUMPTIONS.
- D. MAIN FLOWS, VALVE TYPES AND SIZES PRIORITISED.
- E. LINE NUMBERS STILL IN PROGRESS.
- F. INSTRUMENTS/ALARMS BASED ON MAINTENANCE LIST.
- G. HAND SWITCHES & FAULT ALARMS FOR ALL MOTORS.

- NOTES:
- 1. INSTRUMENT AIR, ACACIA TAILS, ACACIA SUMP LINES REMOVED.
 - 2. RECIRCULATING FILTERS REMOVED.
 - 3. INSTRUMENTS REMOVED FROM LIME SILO.
 - 4. INTERLOCKS, HIGH TEMP ALARMS REMOVED FROM BALL MILL.
 - 5. BALL MILL MONORAIL REMOVED.
 - 6. LEVEL ALARMS AND INSTRUMENTS REMOVED.
 - 7. LEVEL SWITCH REMOVED FROM SUMP PUMP.
 - 8. GLAND WATER AND SAFETY SHOWER LINES NOT ACCURATE.
 - 9. FEEDBACK LOOP SIMPLIFIED.

AS-BUILT


10																																																																																																																																																																																																																																																																																																																																																																																																																																																																																																																																																																																																																																																																																																																																																																																																																																																																																																																																																																																																																																																																																																																																																																																																																																																																																																																																																																																																																				
----	--	--	
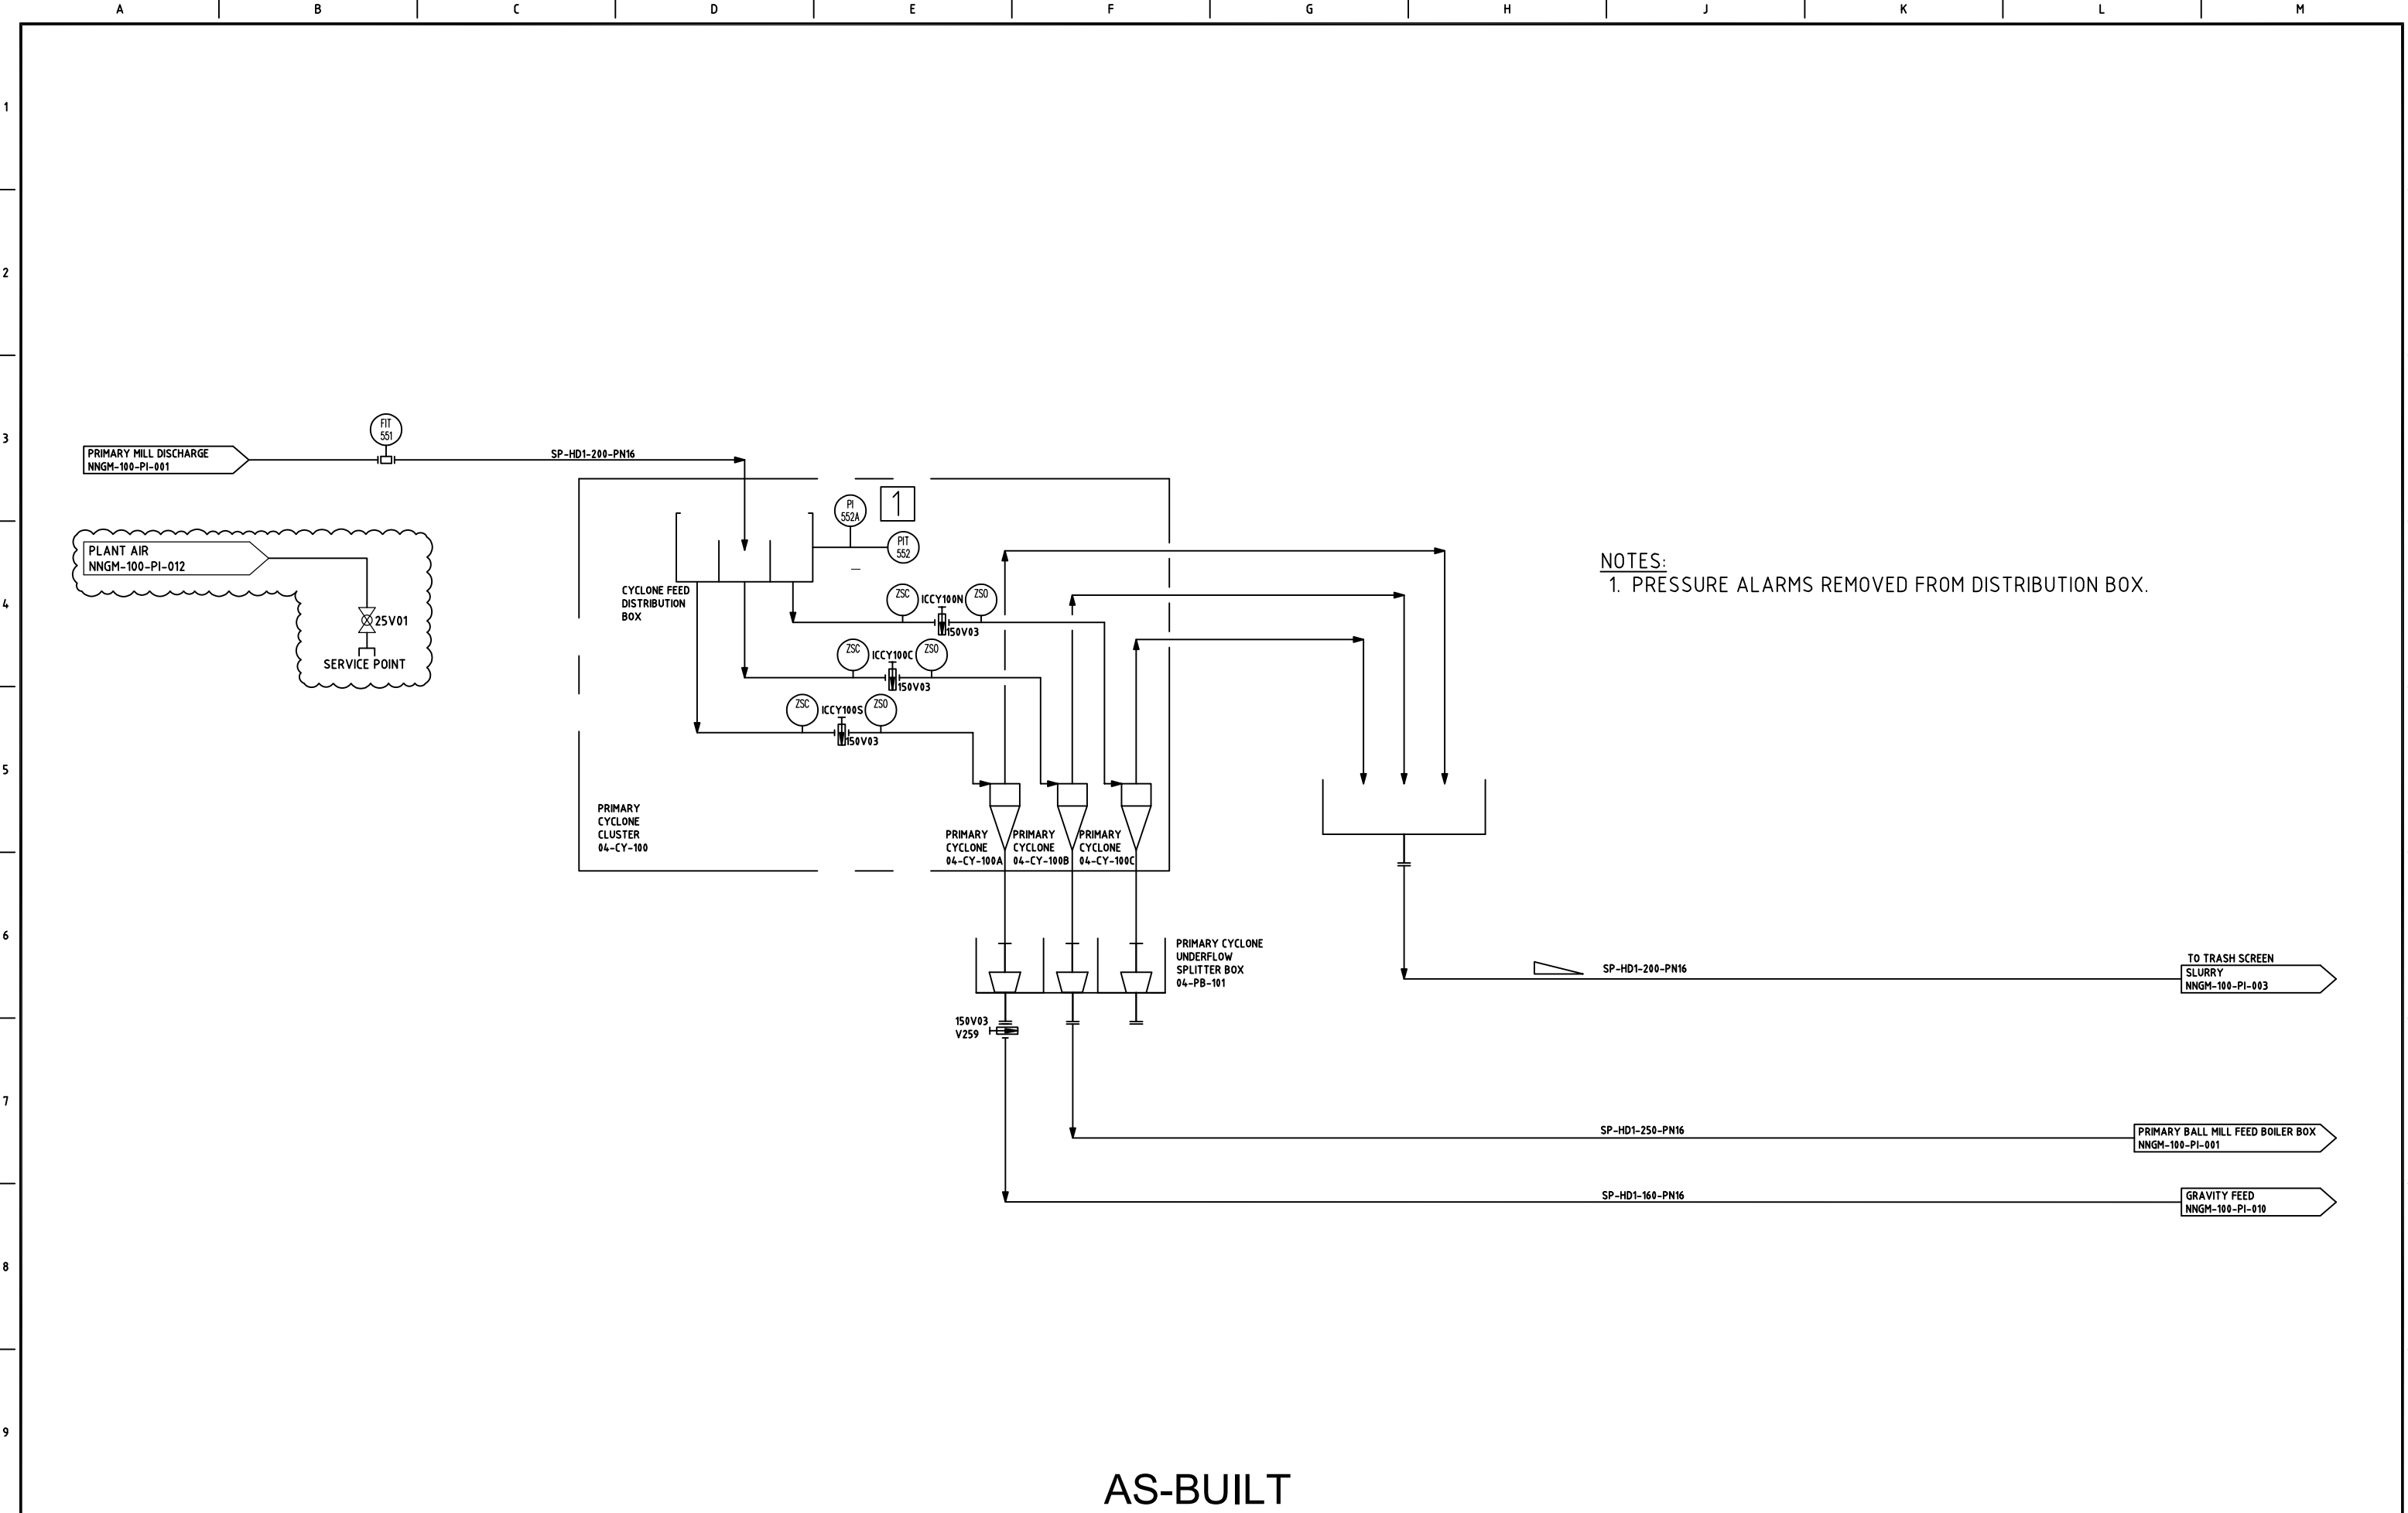

NOTES:
1. PRESSURE ALARMS REMOVED FROM DISTRIBUTION BOX.

AS-BUILT


10																																																																																																																																																																																																																																																																																																																																																																																																																																																																																																																																																																																																																																																																																																																																																																																																																																																																																																																																																																																																																																																																																																																																																																																																																																																																																																																																																																																																																				
----	--	--	
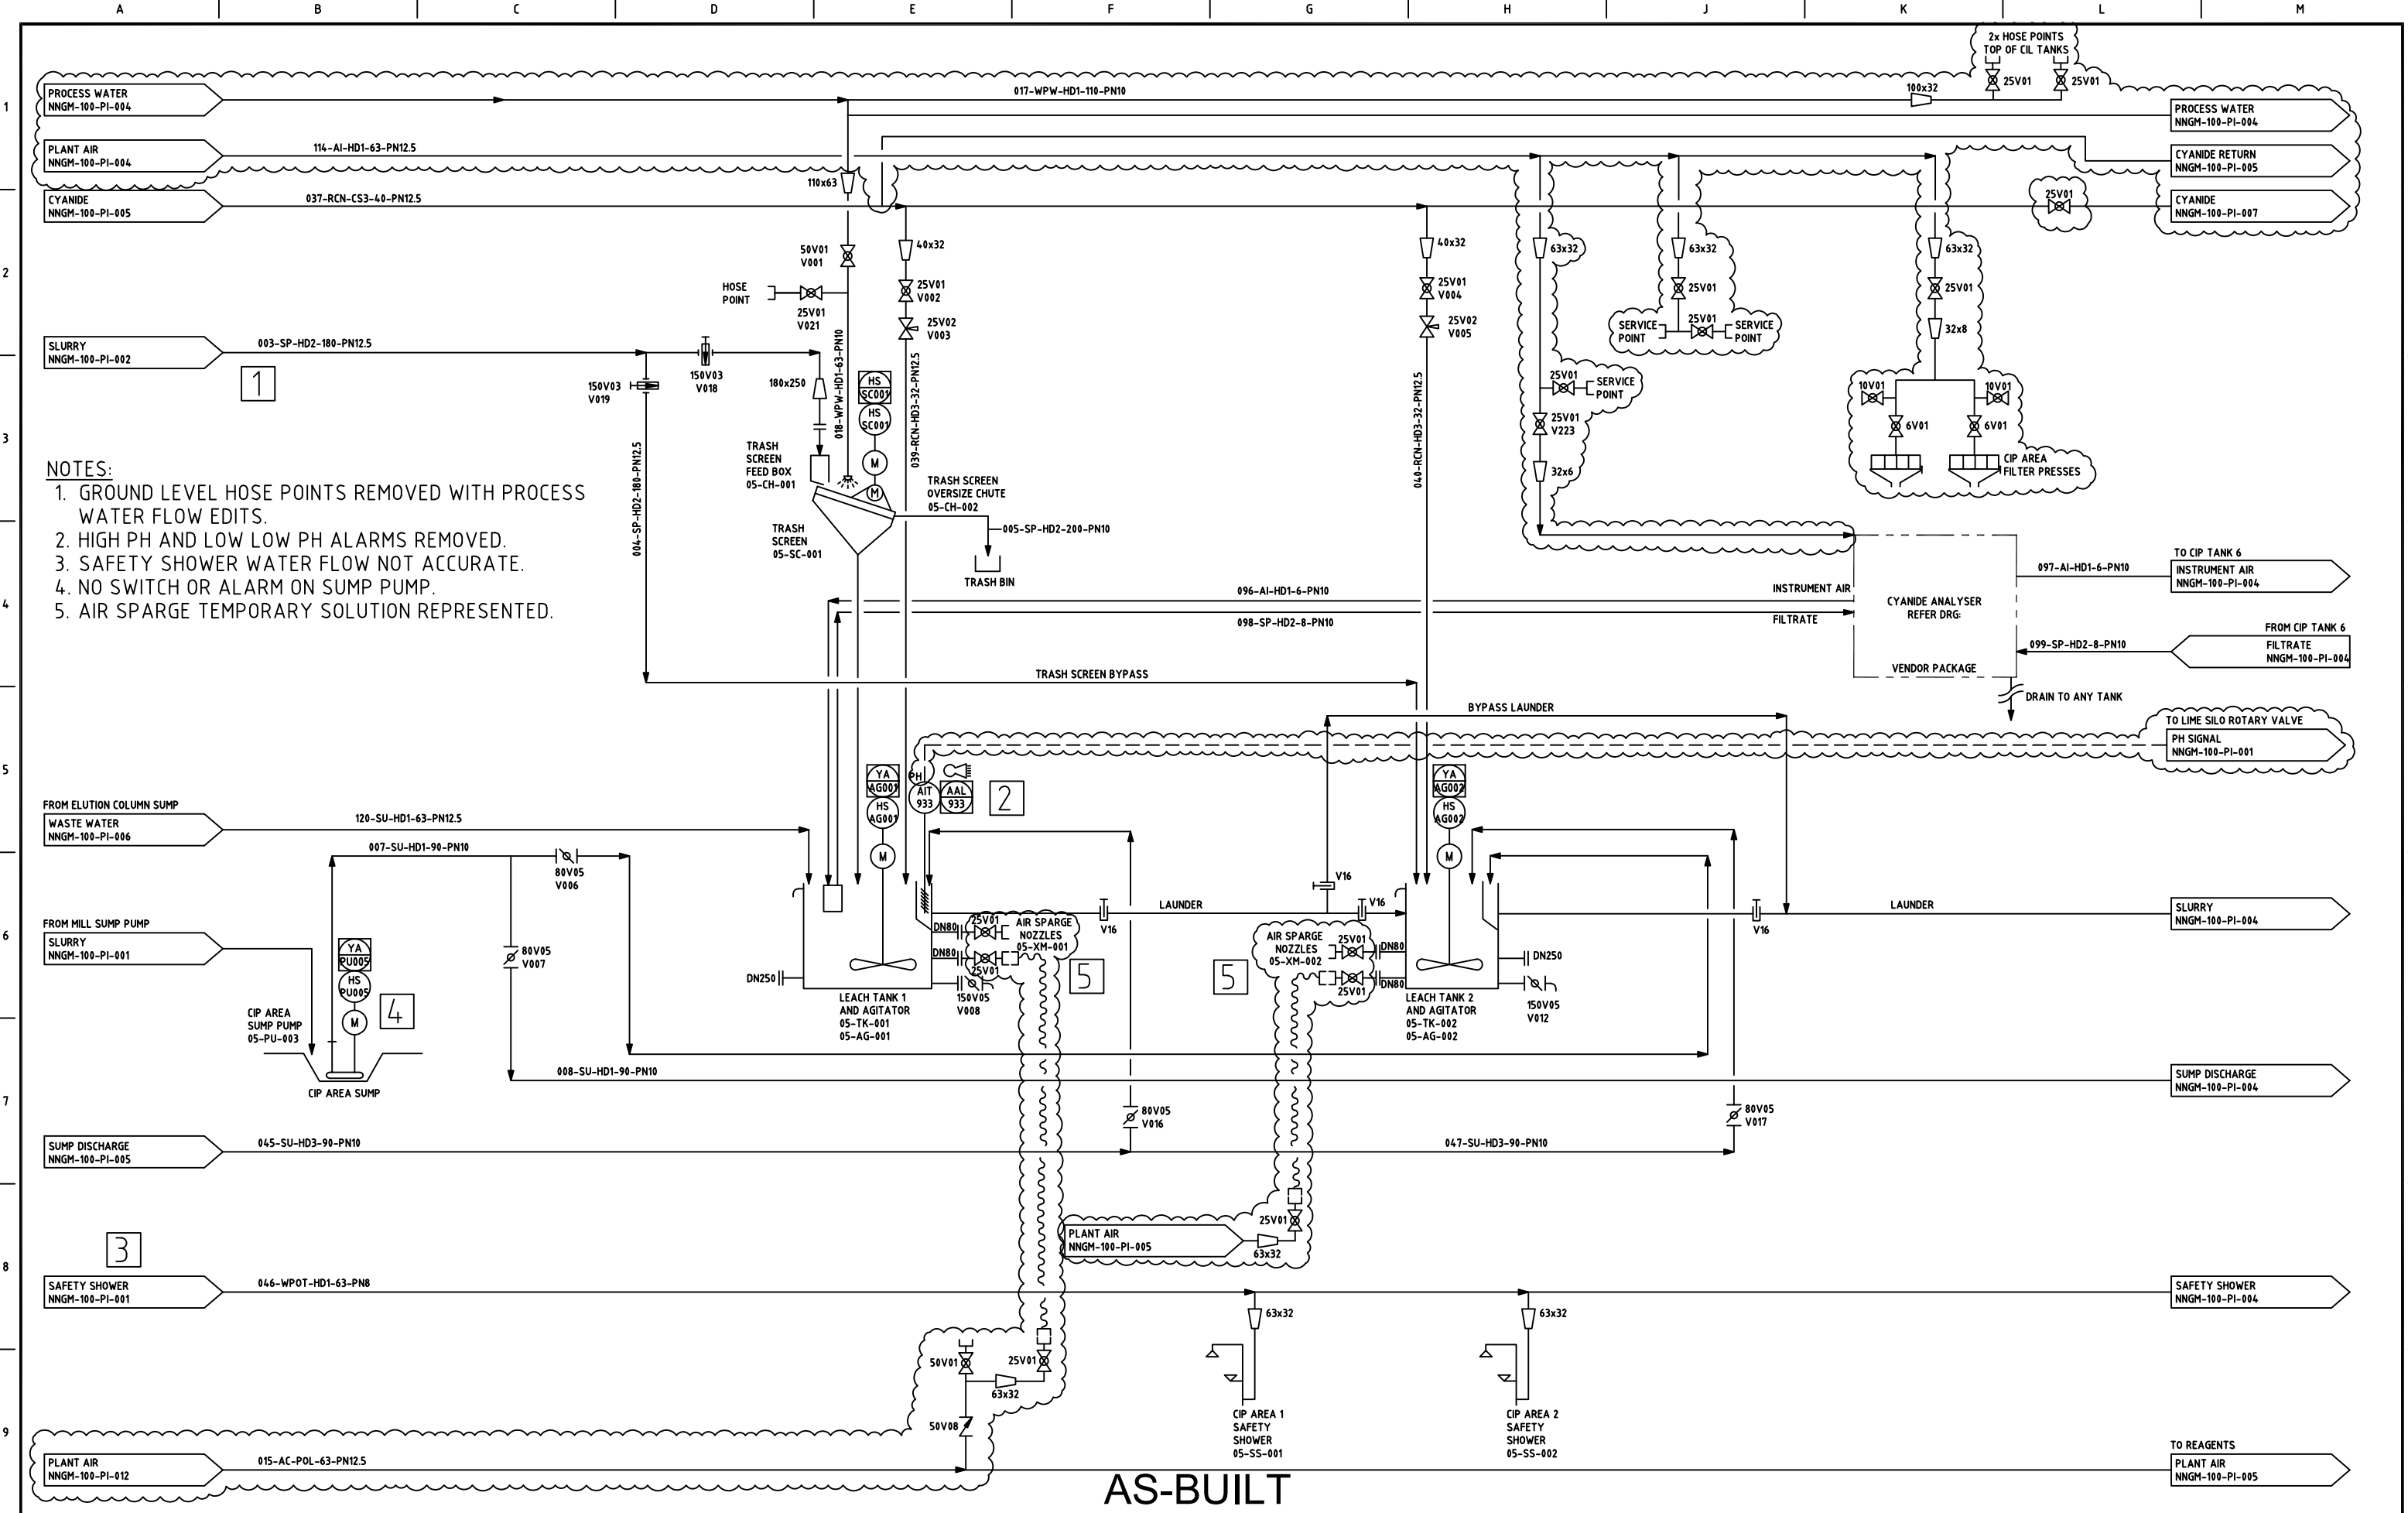

- NOTES:
1. GROUND LEVEL HOSE POINTS REMOVED WITH PROCESS WATER FLOW EDITS.
 2. HIGH PH AND LOW LOW PH ALARMS REMOVED.
 3. SAFETY SHOWER WATER FLOW NOT ACCURATE.
 4. NO SWITCH OR ALARM ON SUMP PUMP.
 5. AIR SPARGE TEMPORARY SOLUTION REPRESENTED.


AS-BUILT

10																																																																																																																																																																																																																																																																																																																																																																																																																																																																																																																																																																																																																																																																																																																																																																																																																																																																																																																																																																																																																																																																																																																																																																																																																																																																																																																																																																																																																																					</
----	--	--	----

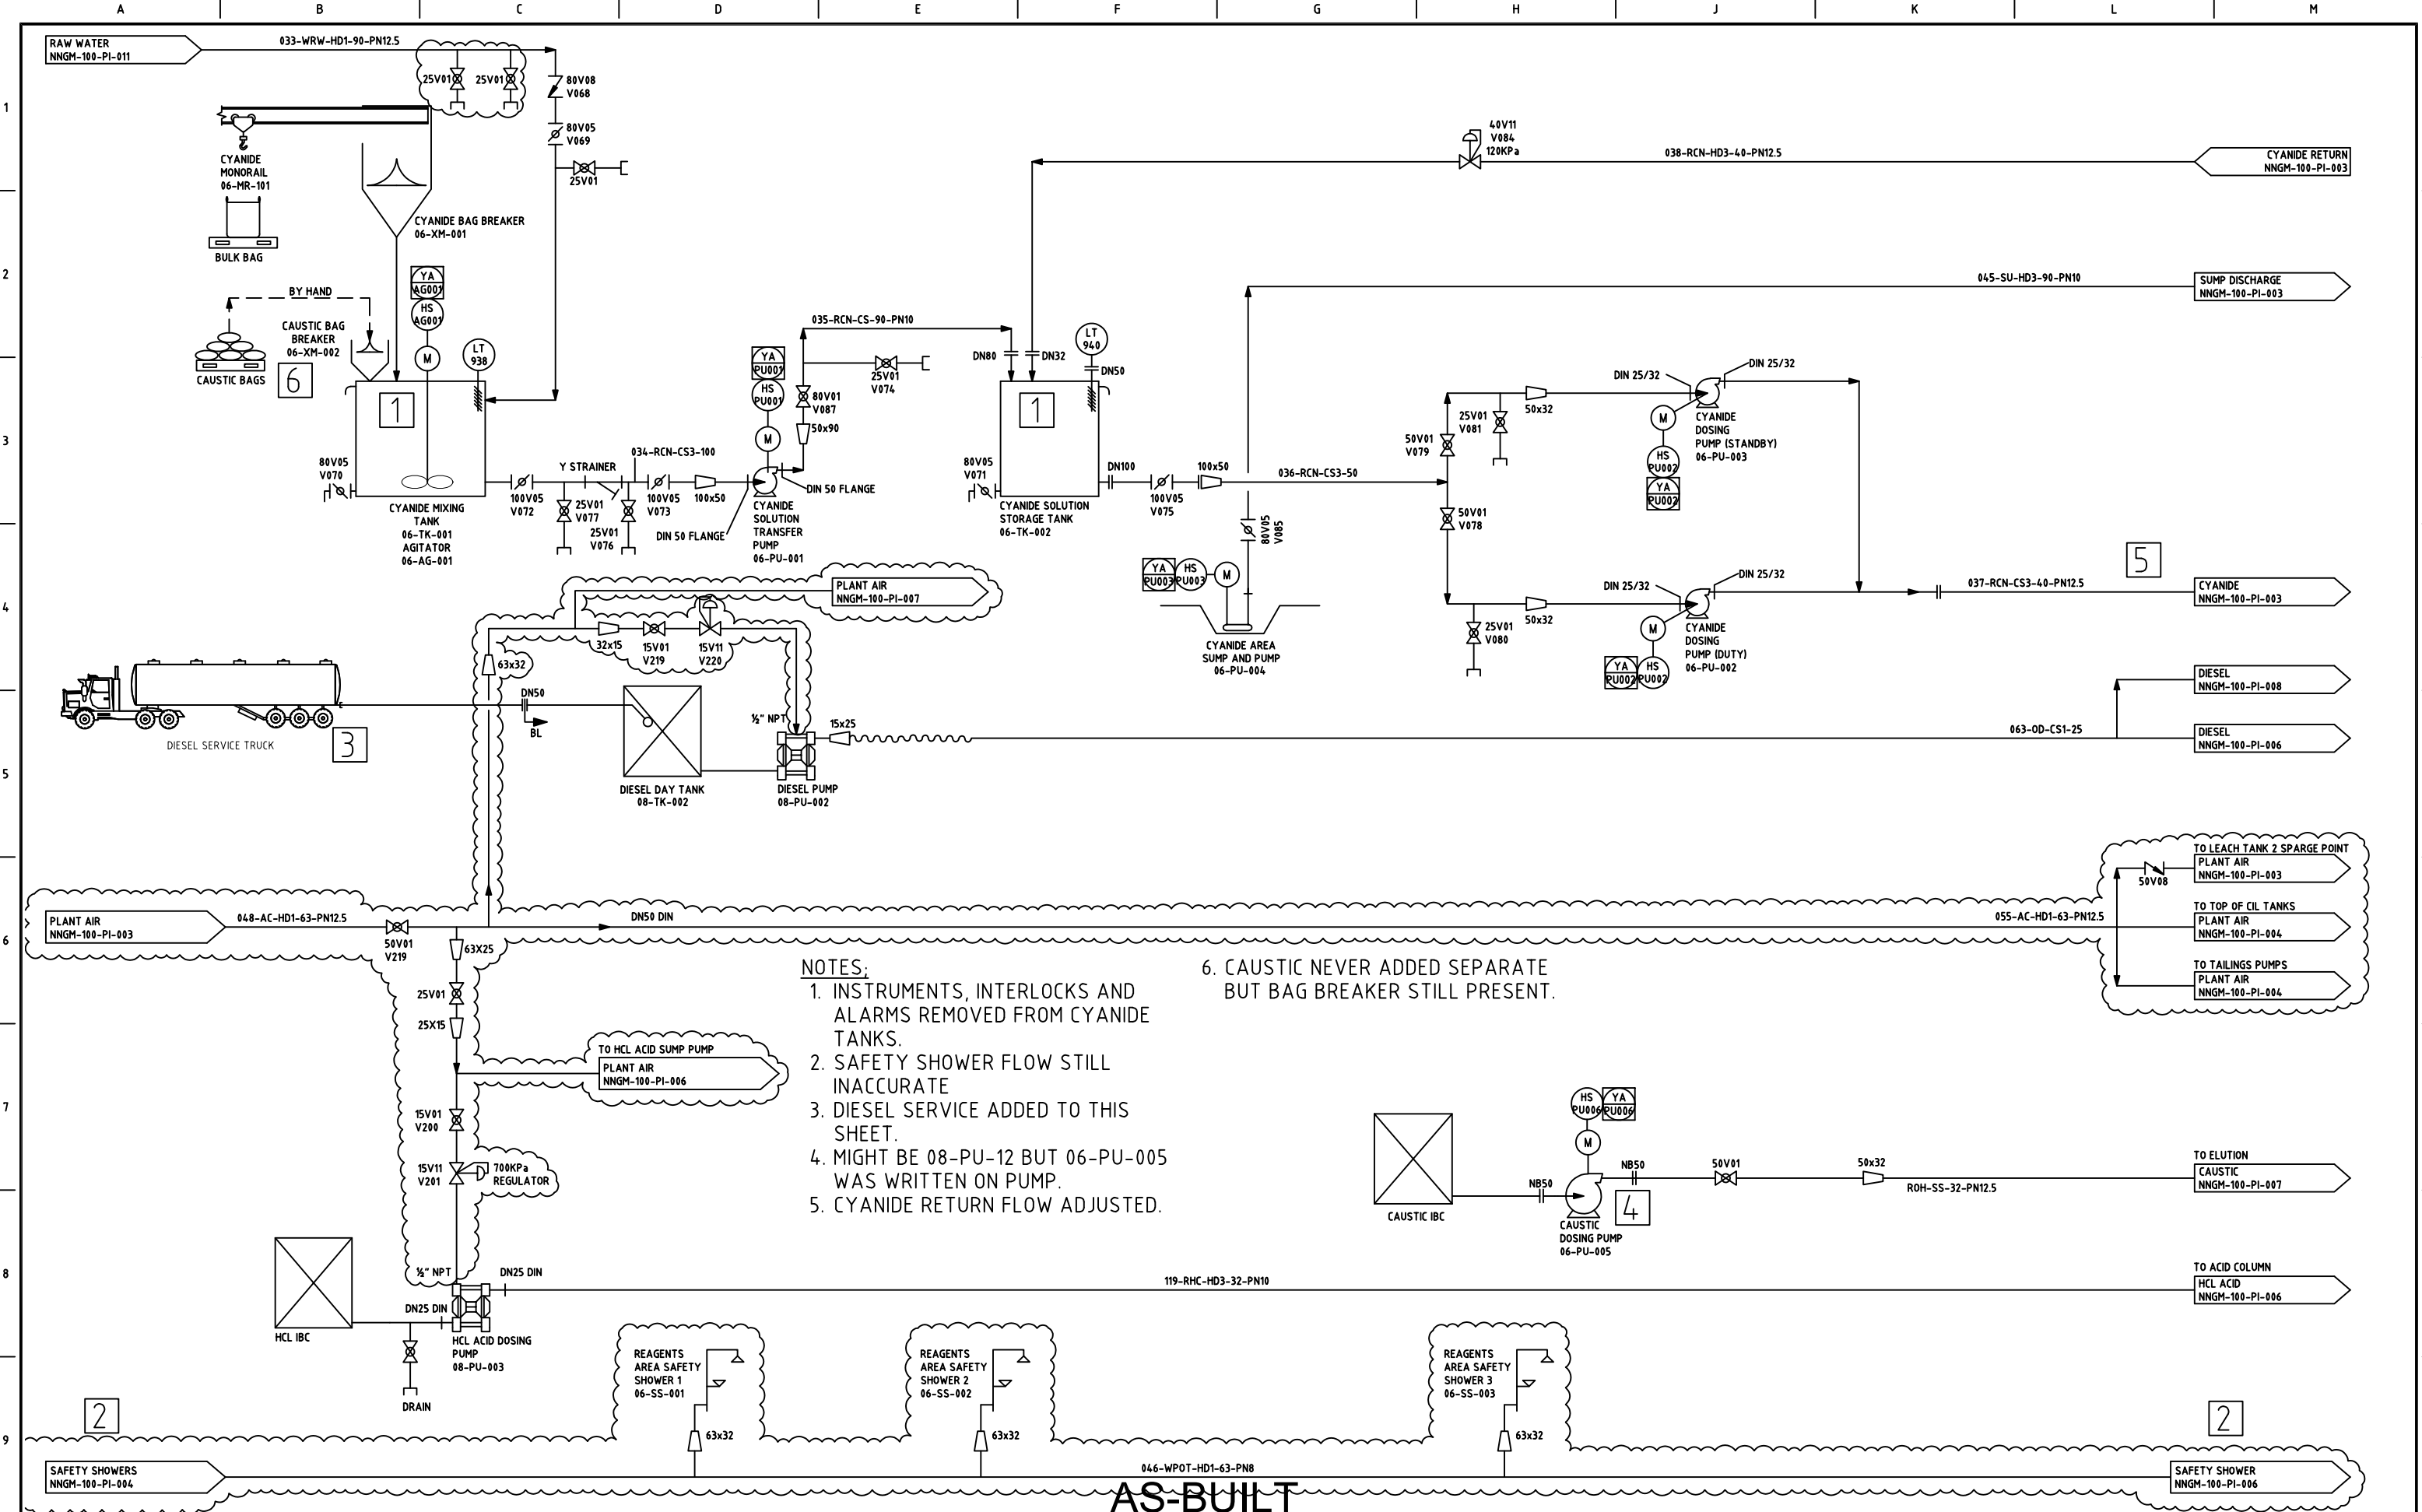


- NOTES:
1. INSTRUMENTS, INTERLOCKS AND ALARMS REMOVED FROM CYANIDE TANKS.
 2. SAFETY SHOWER FLOW STILL INACCURATE
 3. DIESEL SERVICE ADDED TO THIS SHEET.
 4. MIGHT BE 08-PU-12 BUT 06-PU-005 WAS WRITTEN ON PUMP.
 5. CYANIDE RETURN FLOW ADJUSTED.

6. CAUSTIC NEVER ADDED SEPARATE BUT BAG BREAKER STILL PRESENT.

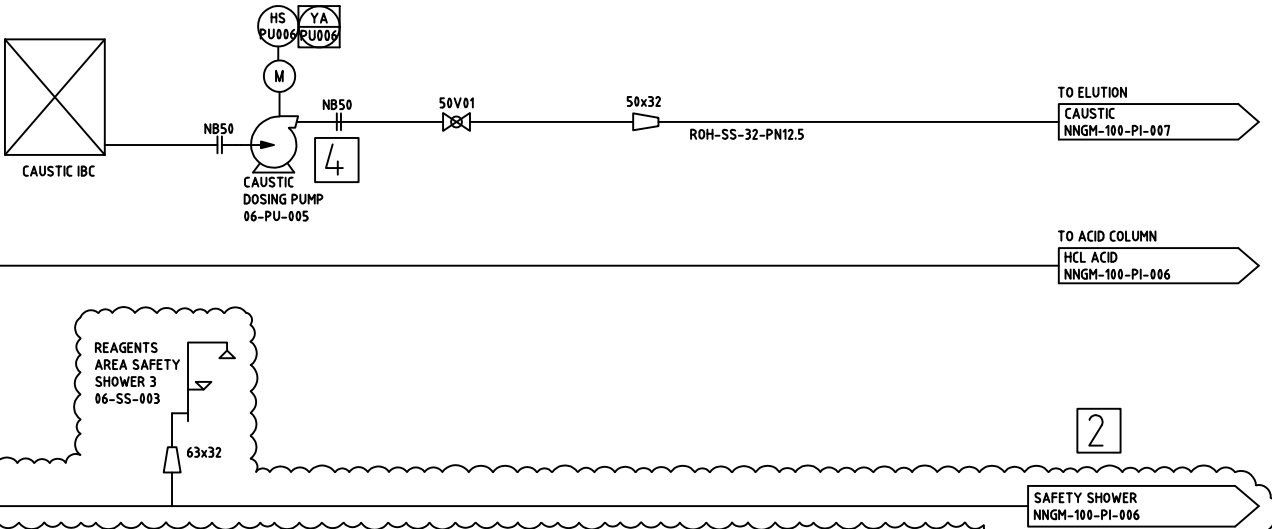


ASPECT										TENNANT MINING					PROJECT: TENNANT MINING PTY LTD NOBLES NOB GOLD MINE				
THIS DRAWING IS THE PROPERTY OF ASPECT ENGINEERING SOLUTIONS PTY LTD AND IS PRIVATE, CONFIDENTIAL AND IS SUPPLIED ON THE EXPRESS UNDERSTANDING THAT IT IS NOT TO BE USED FOR ANY PURPOSE OR COMMUNICATED TO ANY OTHER PERSON WITHOUT THE WRITTEN PERMISSION OF THE PROPRIETORS.										TITLE: REAGENTS PIPING AND INSTRUMENTATION DIAGRAM					SHEET A1 SCALE NTS DRG No. NNGM-100-PI-005 REVISION 0				
REV										DATE					DESCRIPTION				
DRAW										CHECK					DESIGN				
TECH APP										PROJ APP					REFERENCES				
DRG No.																			

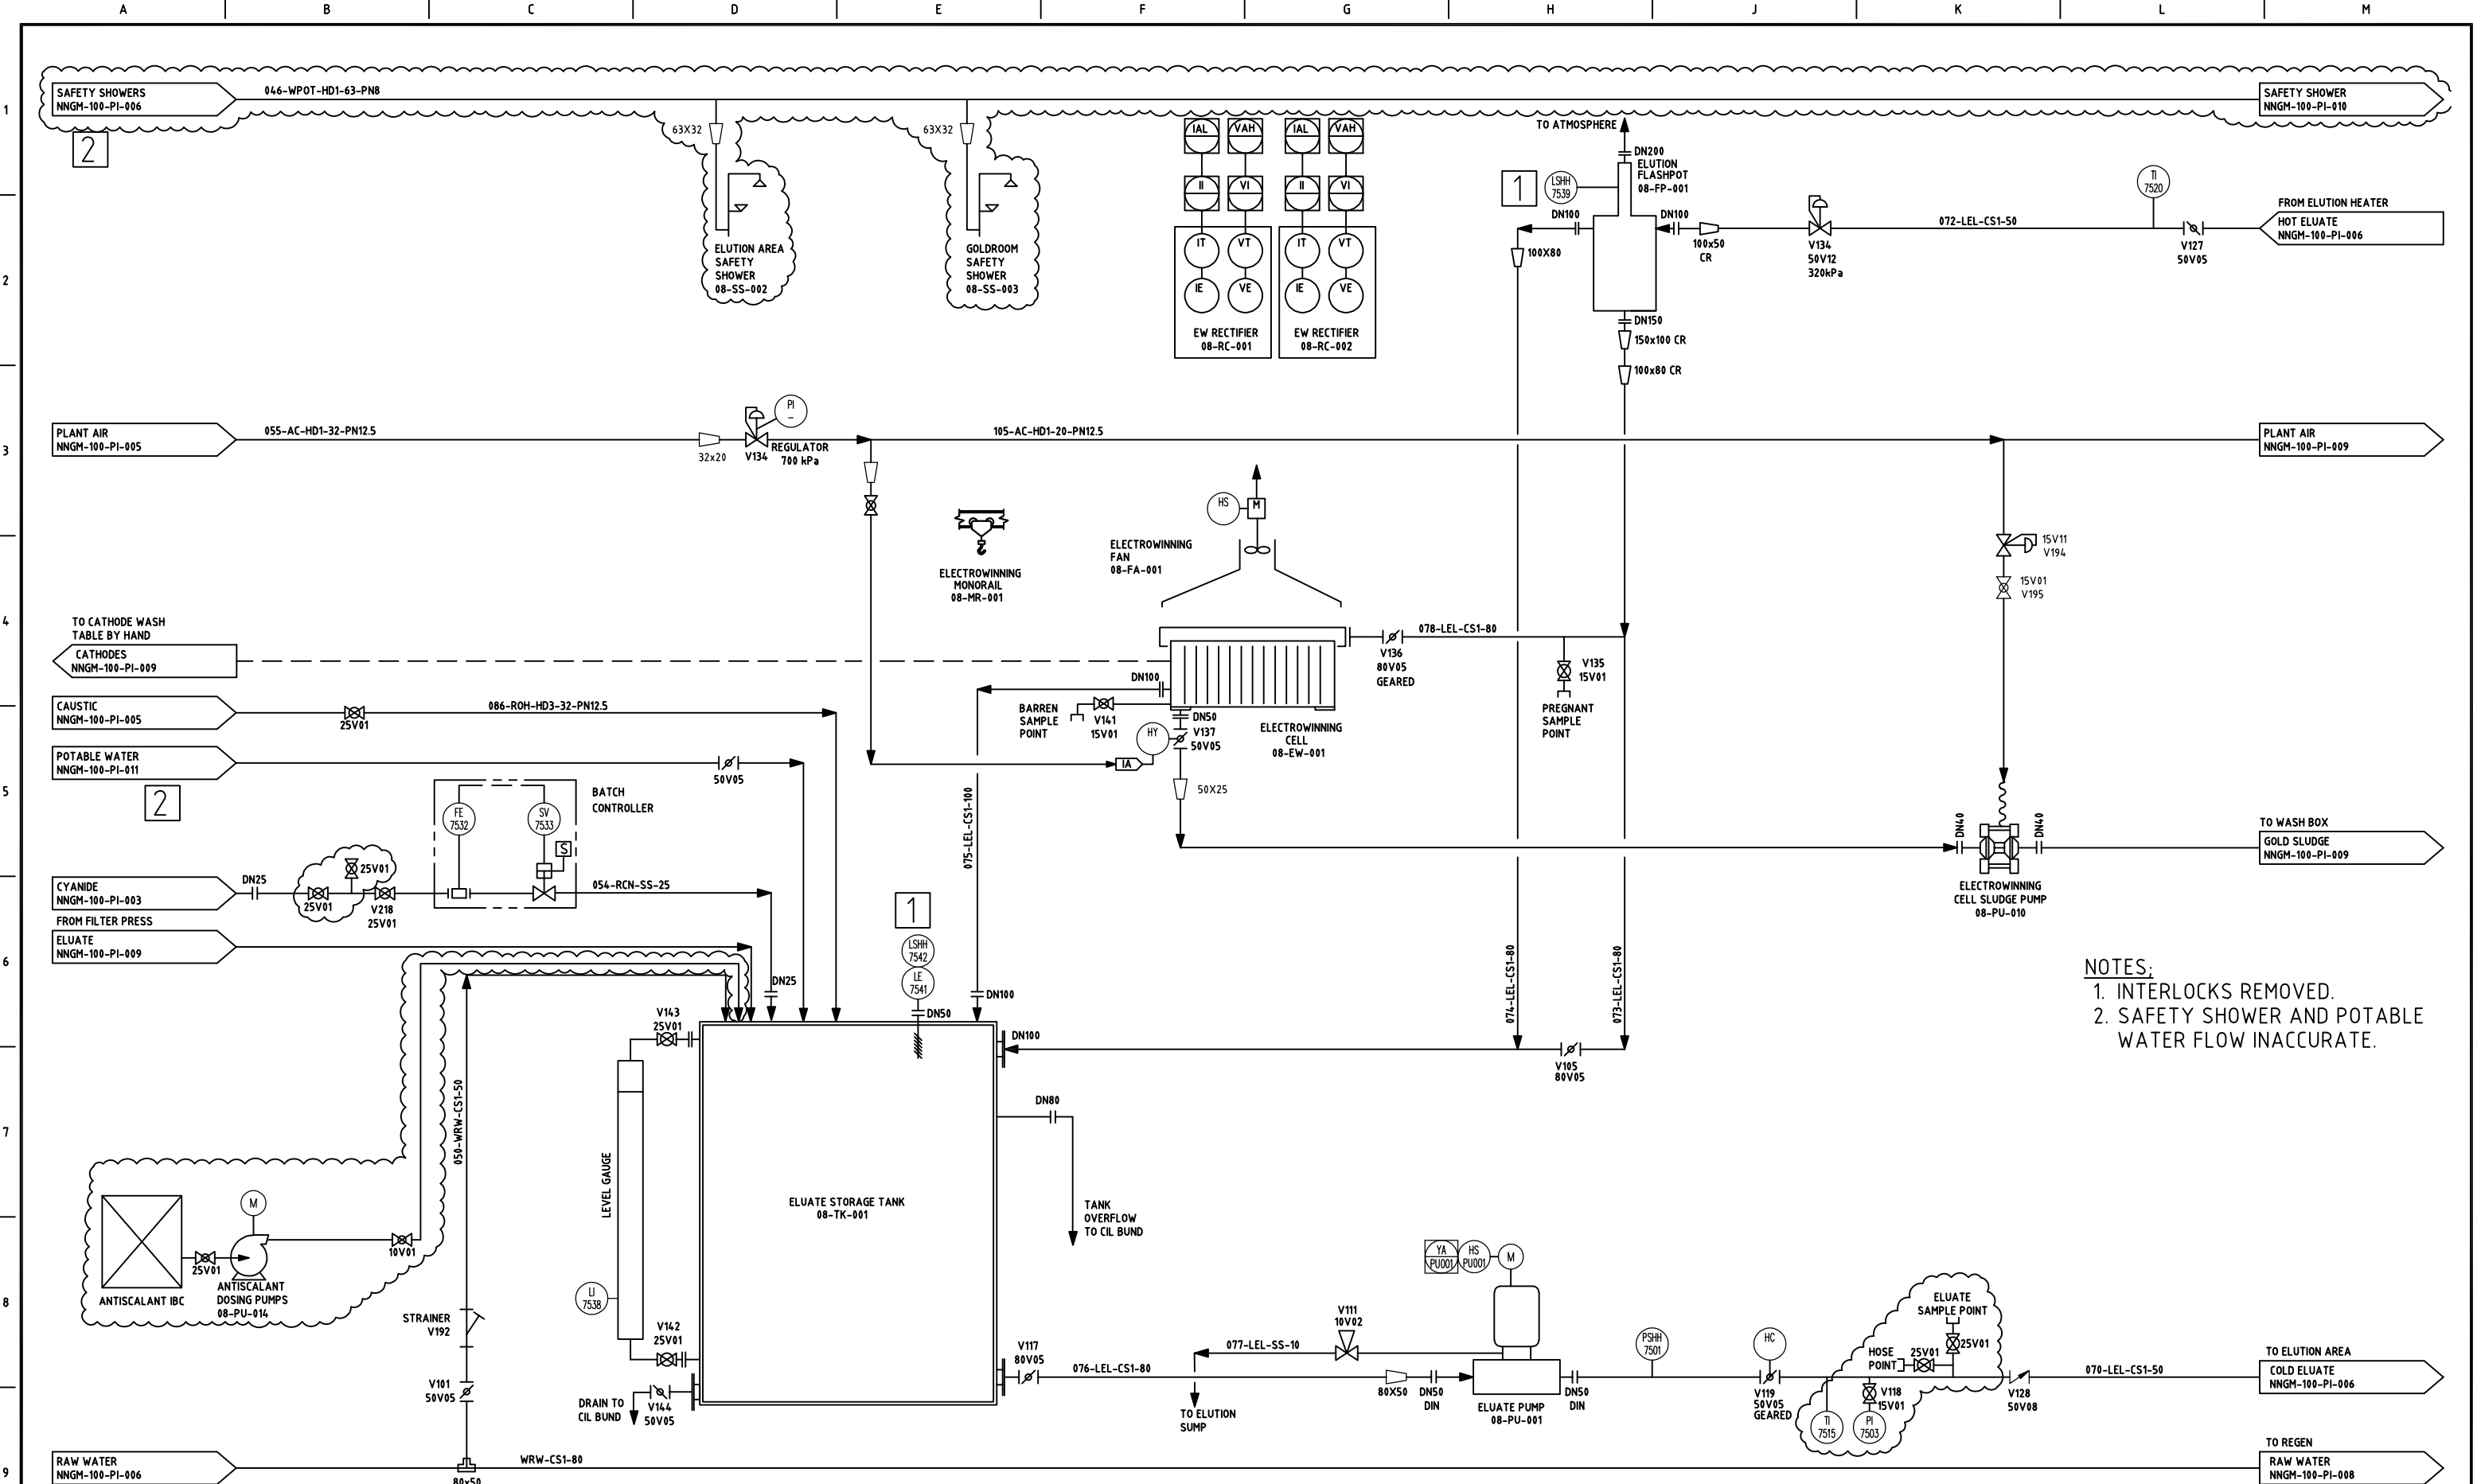

- NOTES:
- 1. INTERLOCKS REMOVED.
 - 2. SAFETY SHOWER AND POTABLE WATER FLOW INACCURATE.

AS-BUILT


10																																																																																																																																																																																																																																																																																																																																																																																																																																																																																																																																																																																																																																																																																																																																																																																																																																																																																																																																																																																																																																																																																																																																																																																																																																																																																																																																																																																																																							
----	--	--	
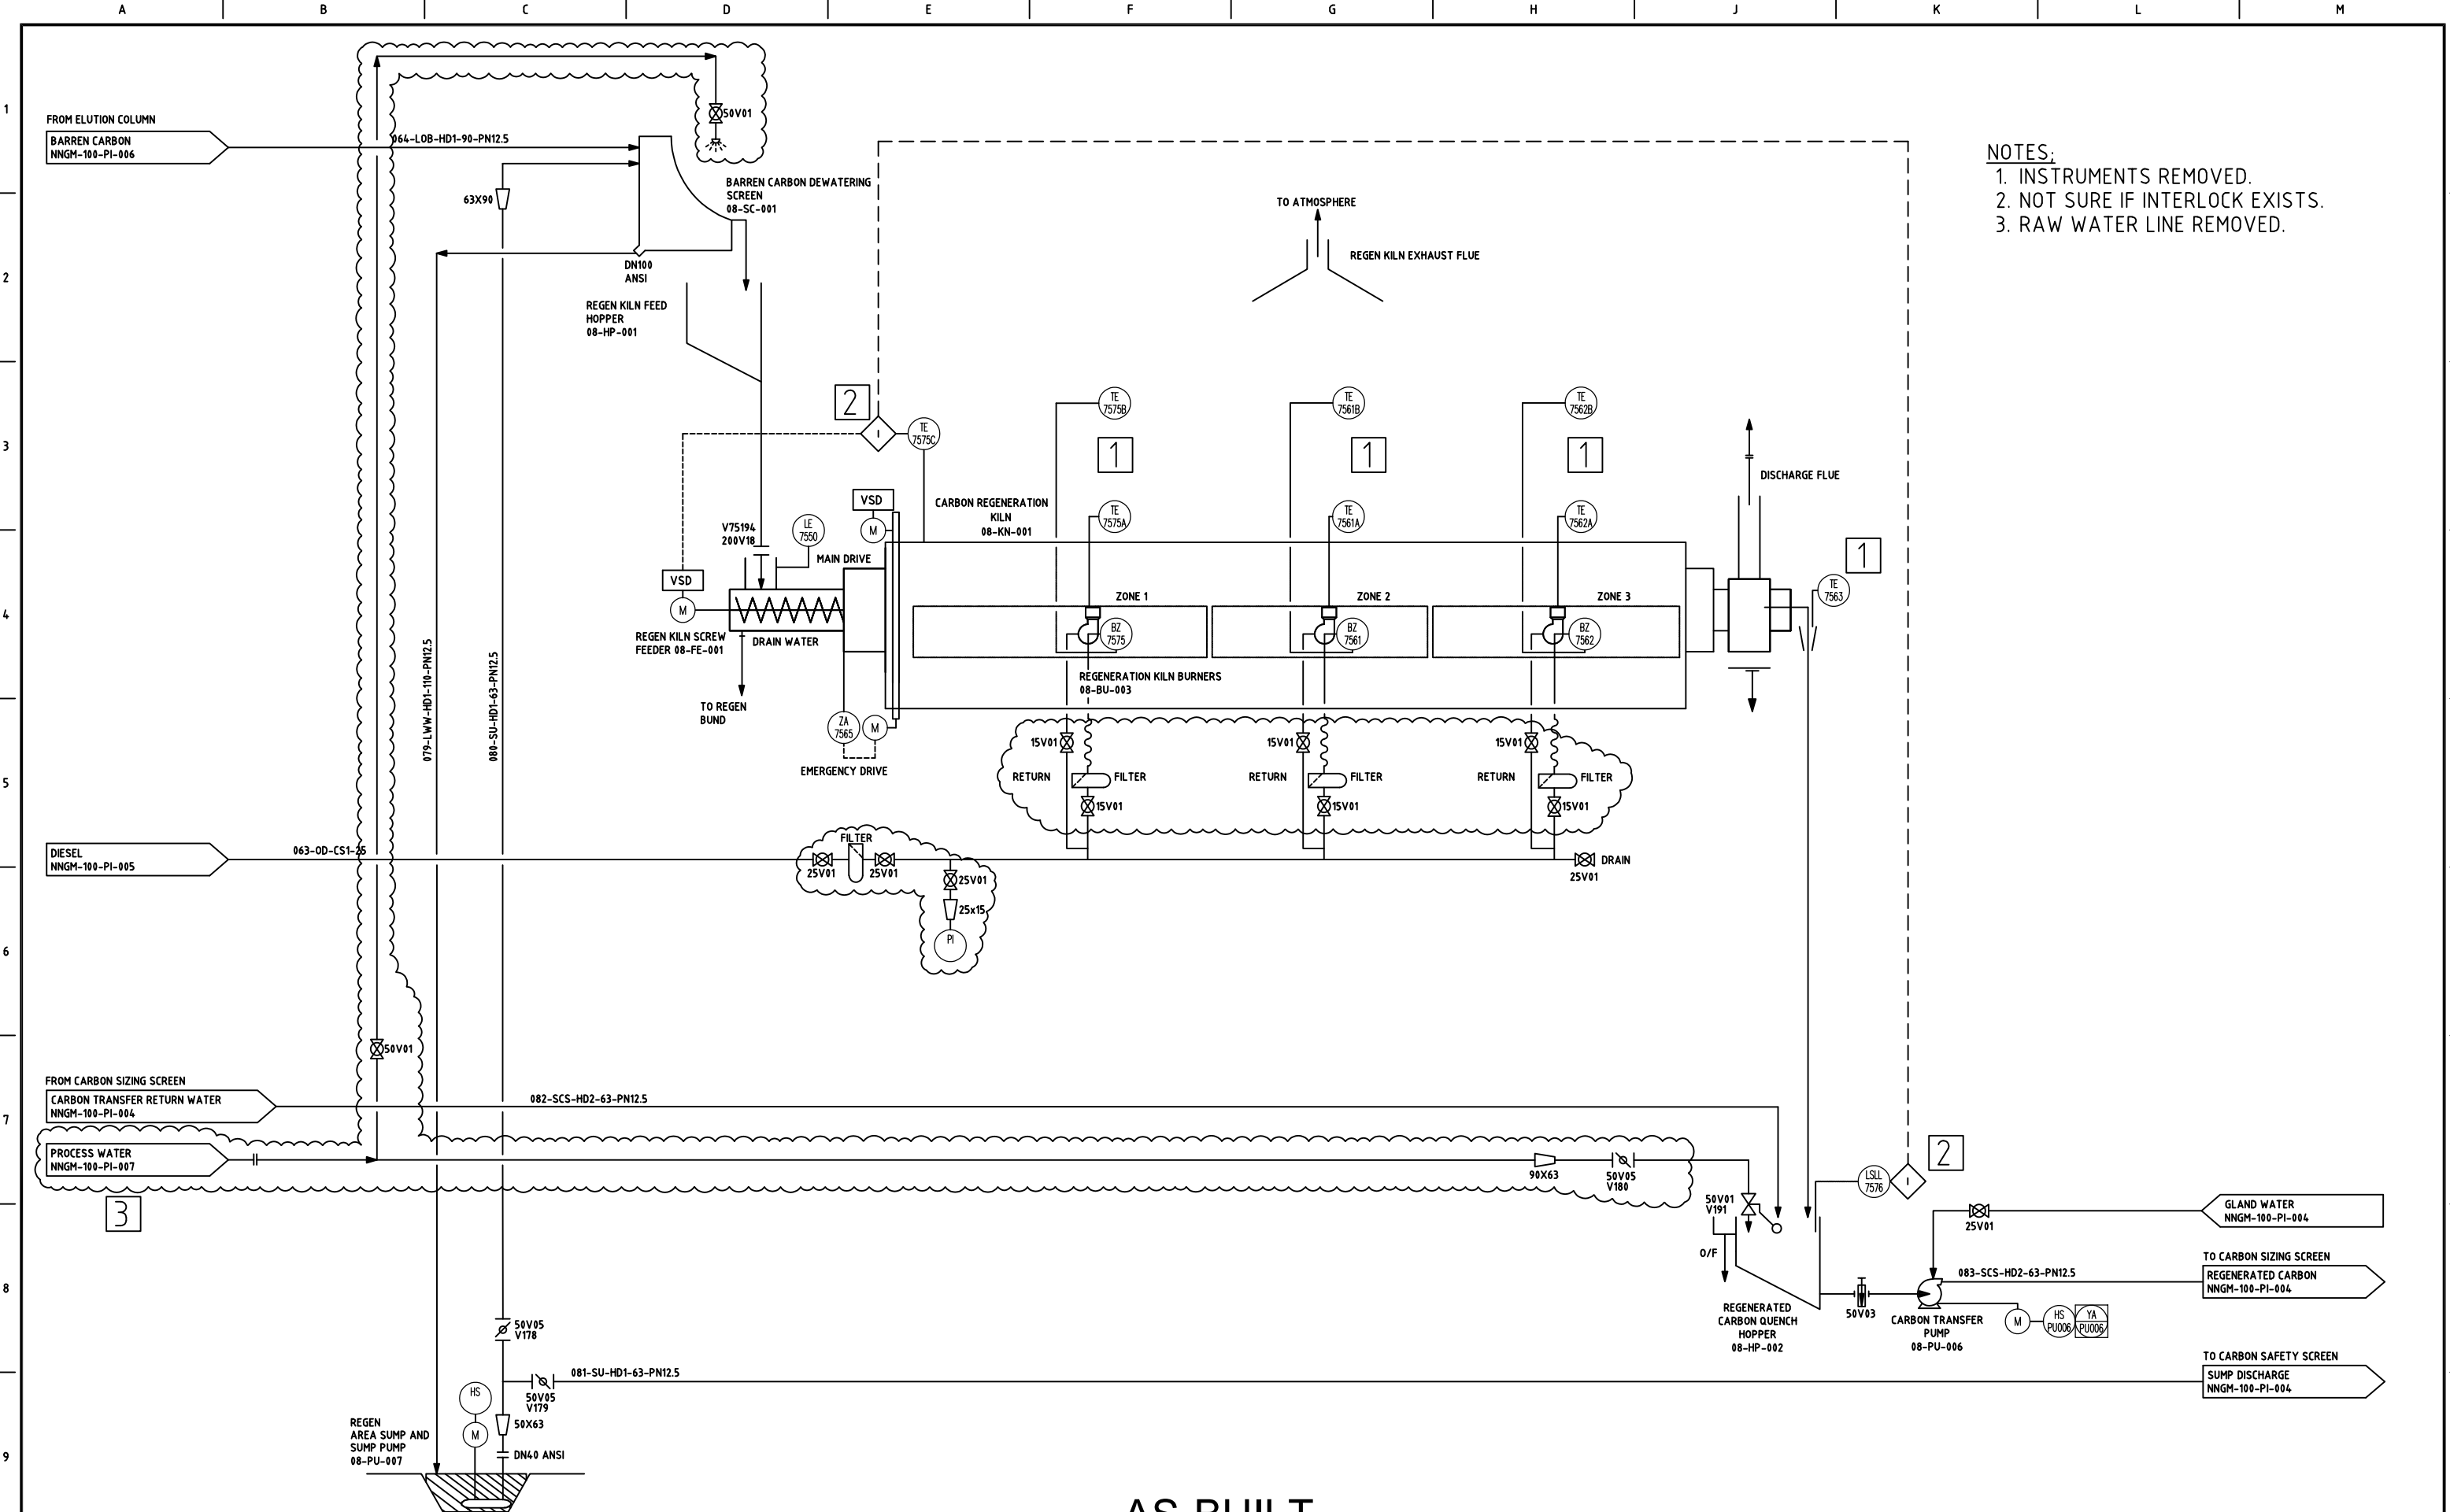

- NOTES:
- 1. INSTRUMENTS REMOVED.
 - 2. NOT SURE IF INTERLOCK EXISTS.
 - 3. RAW WATER LINE REMOVED.

AS-BUILT

10																																																																																																																																																																																																																																																																																																																																																																																																																																																																																																																																																																																																																																																																																																																																																																																																																																																																																																																																																																																																																																																																																																																																																																																																																																																																																																																																																																																																																						</
----	--	--	----

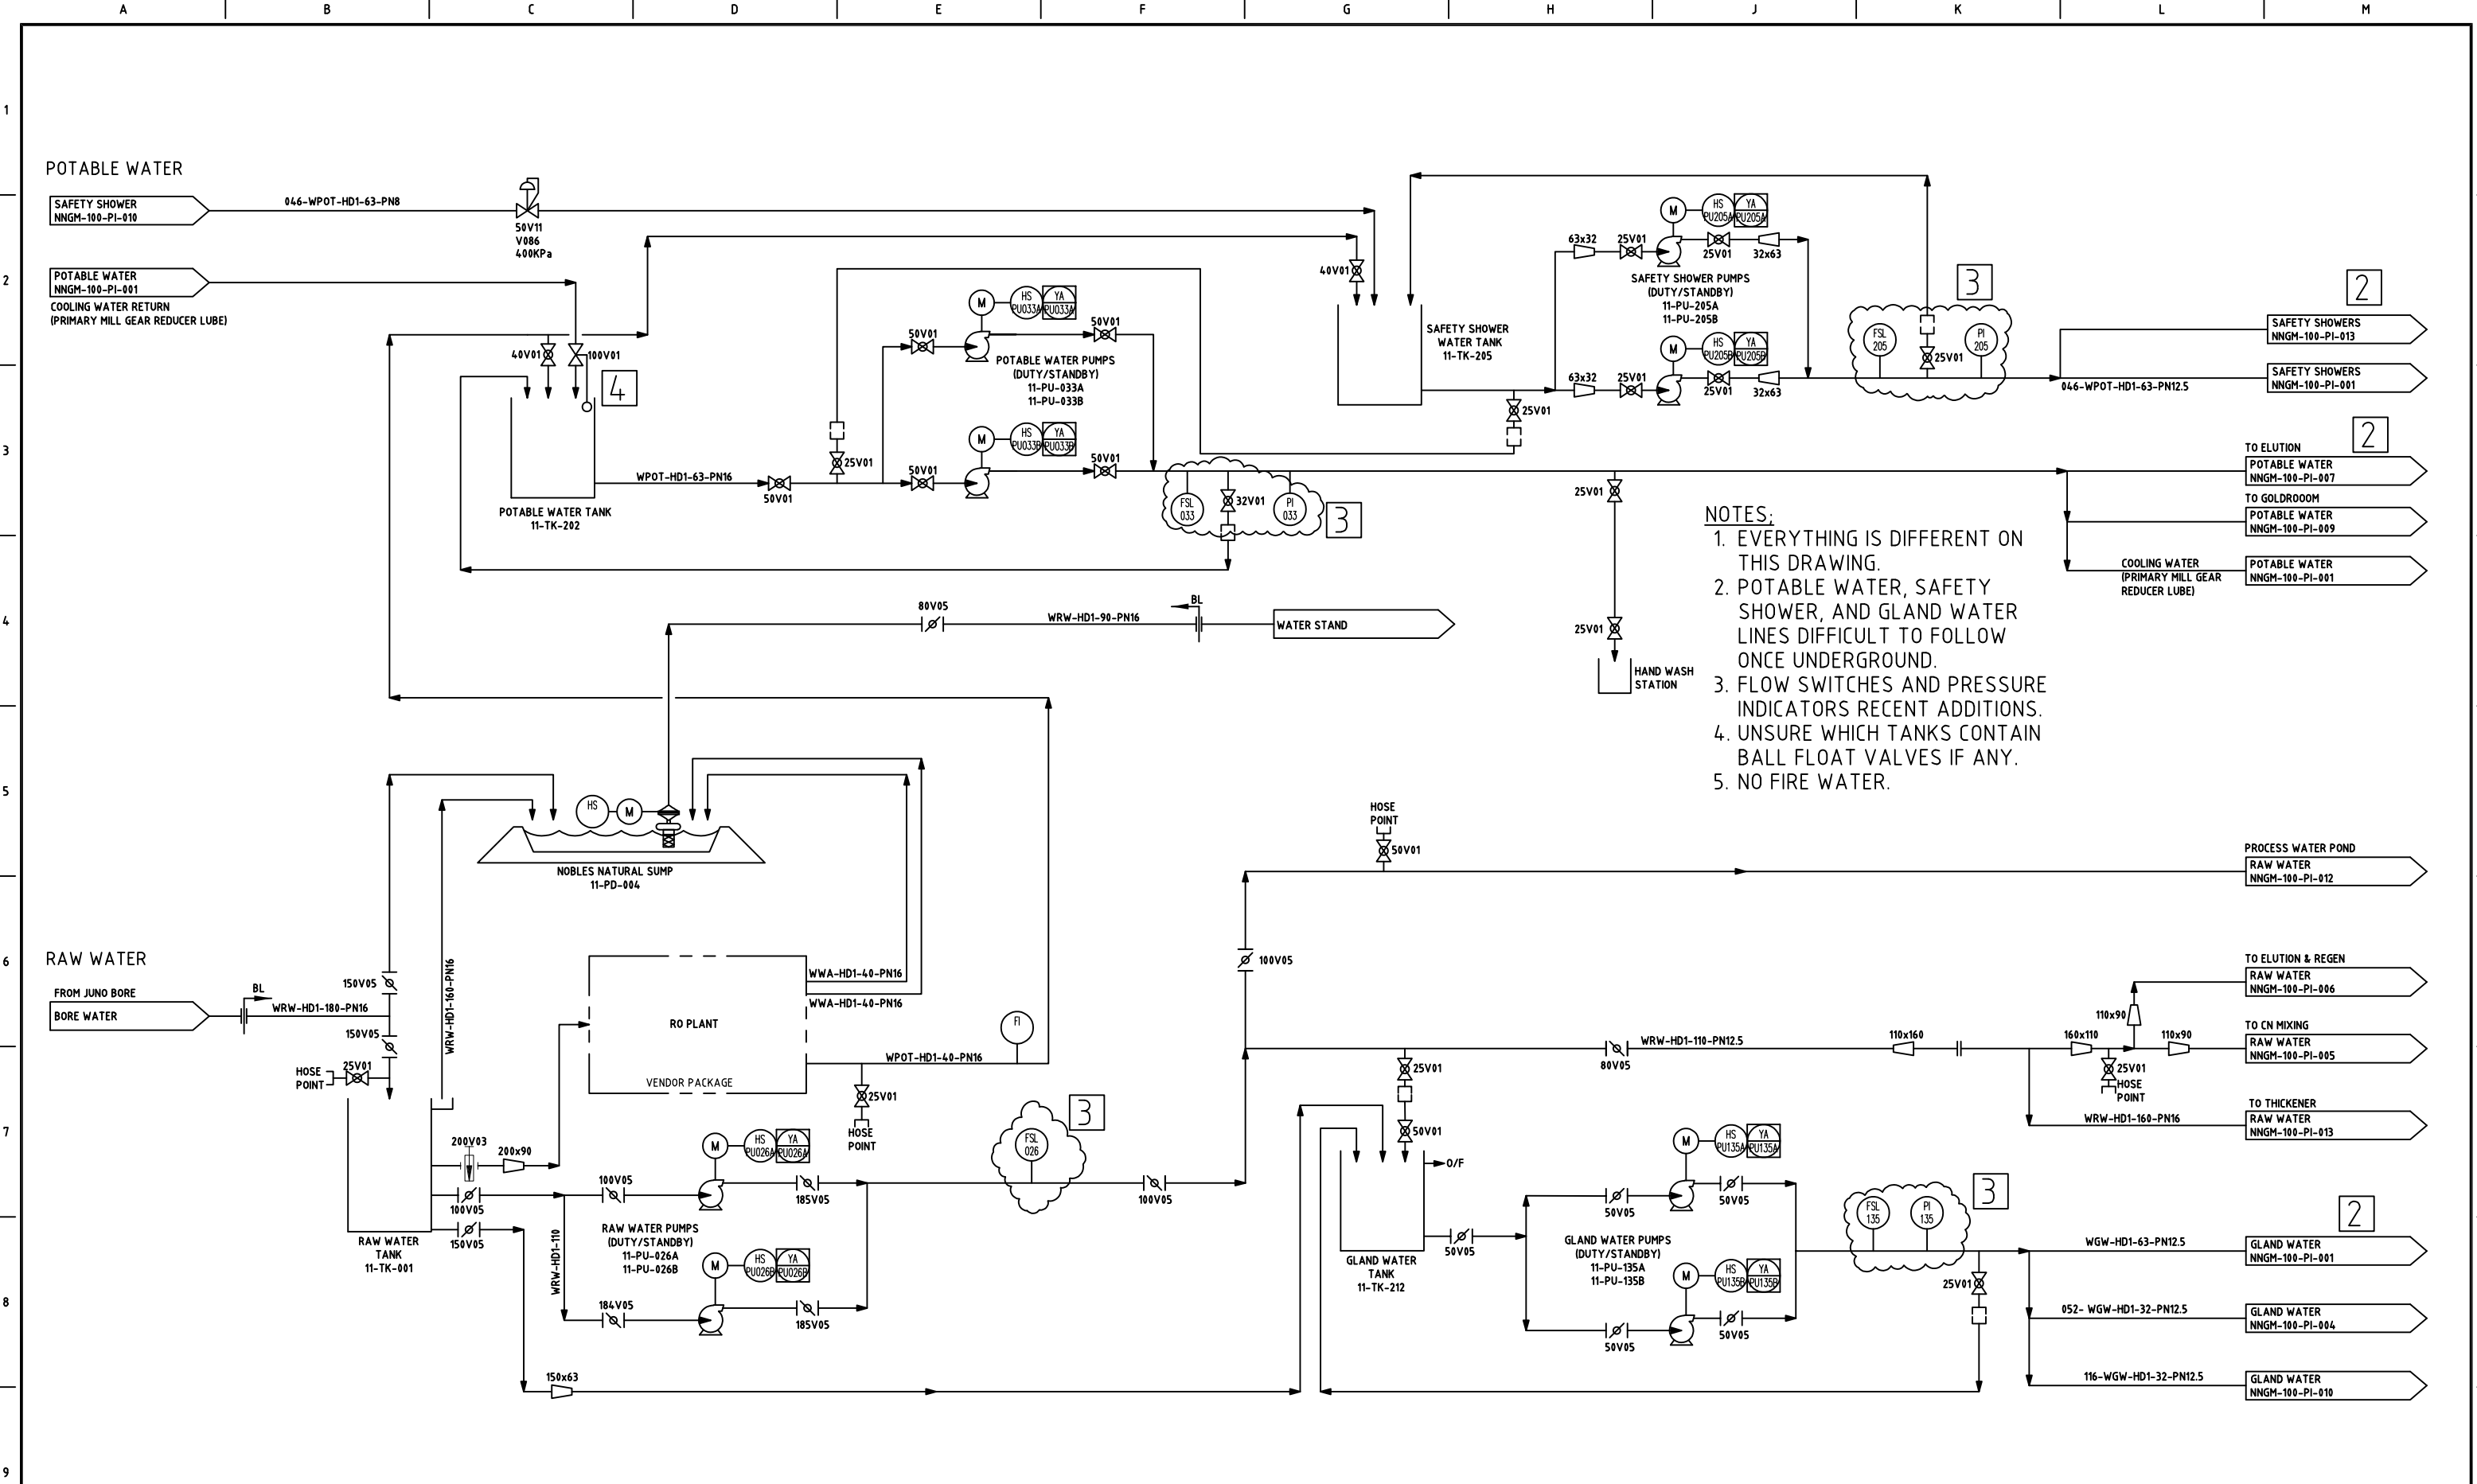


- NOTES:
- 1. EVERYTHING IS DIFFERENT ON THIS DRAWING.
 - 2. POTABLE WATER, SAFETY SHOWER, AND GLAND WATER LINES DIFFICULT TO FOLLOW ONCE UNDERGROUND.
 - 3. FLOW SWITCHES AND PRESSURE INDICATORS RECENT ADDITIONS.
 - 4. UNSURE WHICH TANKS CONTAIN BALL FLOAT VALVES IF ANY.
 - 5. NO FIRE WATER.

AS-BUILT

10																																																																																																																																																																																																																																																																																																																																																																																																																																																																																																																																																																																																																																																																																																																																																																																																																																																																																																																																																																																																																																																																																																																																																																																																																																																																																																																																																																																																																																						
----	--	--	
1. ANTISCALANT DOSING NOT CURRENTLY IN USE.
2. ALL AIR IS JUST PLANT AIR AND THERE ISN'T A SEPARATE AIR DRYER.
3. ALARMS ON AIR RECEIVERS REMOVED.
4. PROCESS WATER FLOW AND PRESSURE INSTRUMENTS + ALARMS NOT PRESENT.

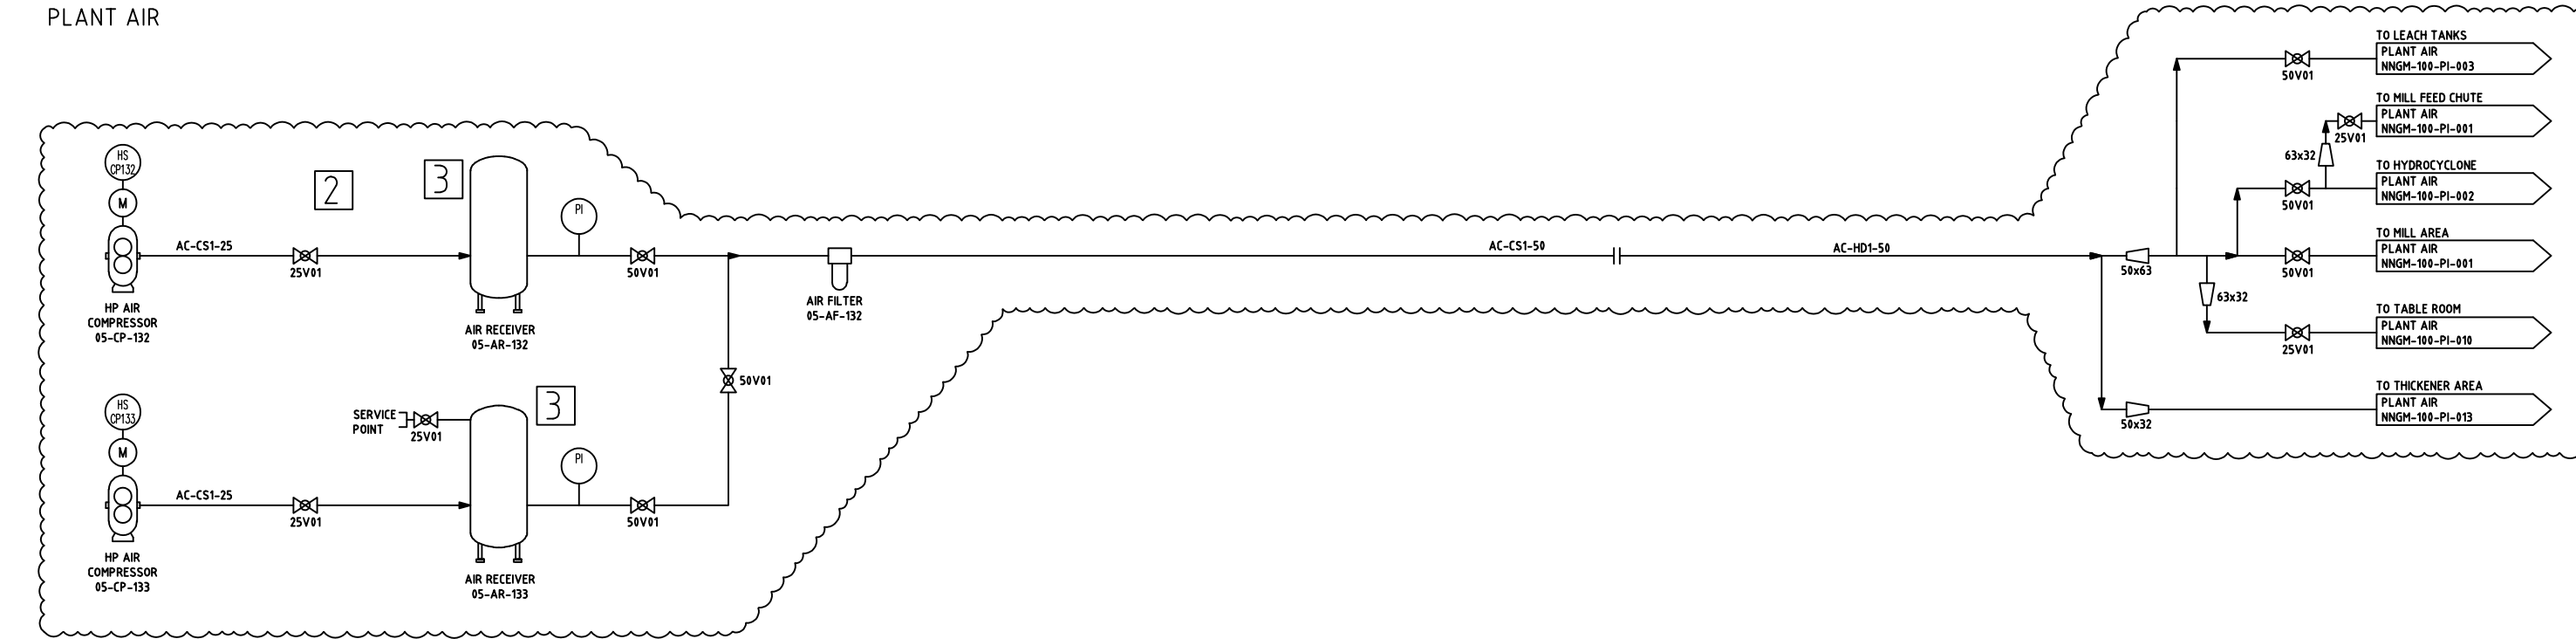

ASPECT

THIS DRAWING IS THE PROPERTY OF ASPECT ENGINEERING SOLUTIONS PTY LTD AND IS PRIVATE, CONFIDENTIAL AND IS SUPPLIED ON THE EXPRESS UNDERSTANDING THAT IT IS NOT TO BE USED FOR ANY PURPOSE OR COPIED OR COMMUNICATED TO ANY OTHER PERSON WITHOUT THE WRITTEN PERMISSION OF THE PROPRIETORS.



PROJECT: TENNANT MINING PTY LTD NOBLES NOB GOLD MINE			
TITLE: PROCESS WATER AND AIR SERVICES PIPING AND INSTRUMENTATION DIAGRAM			
SHEET A1	SCALE NTS	DRG No. NNGM-100-PI-012	REVISION 0

